

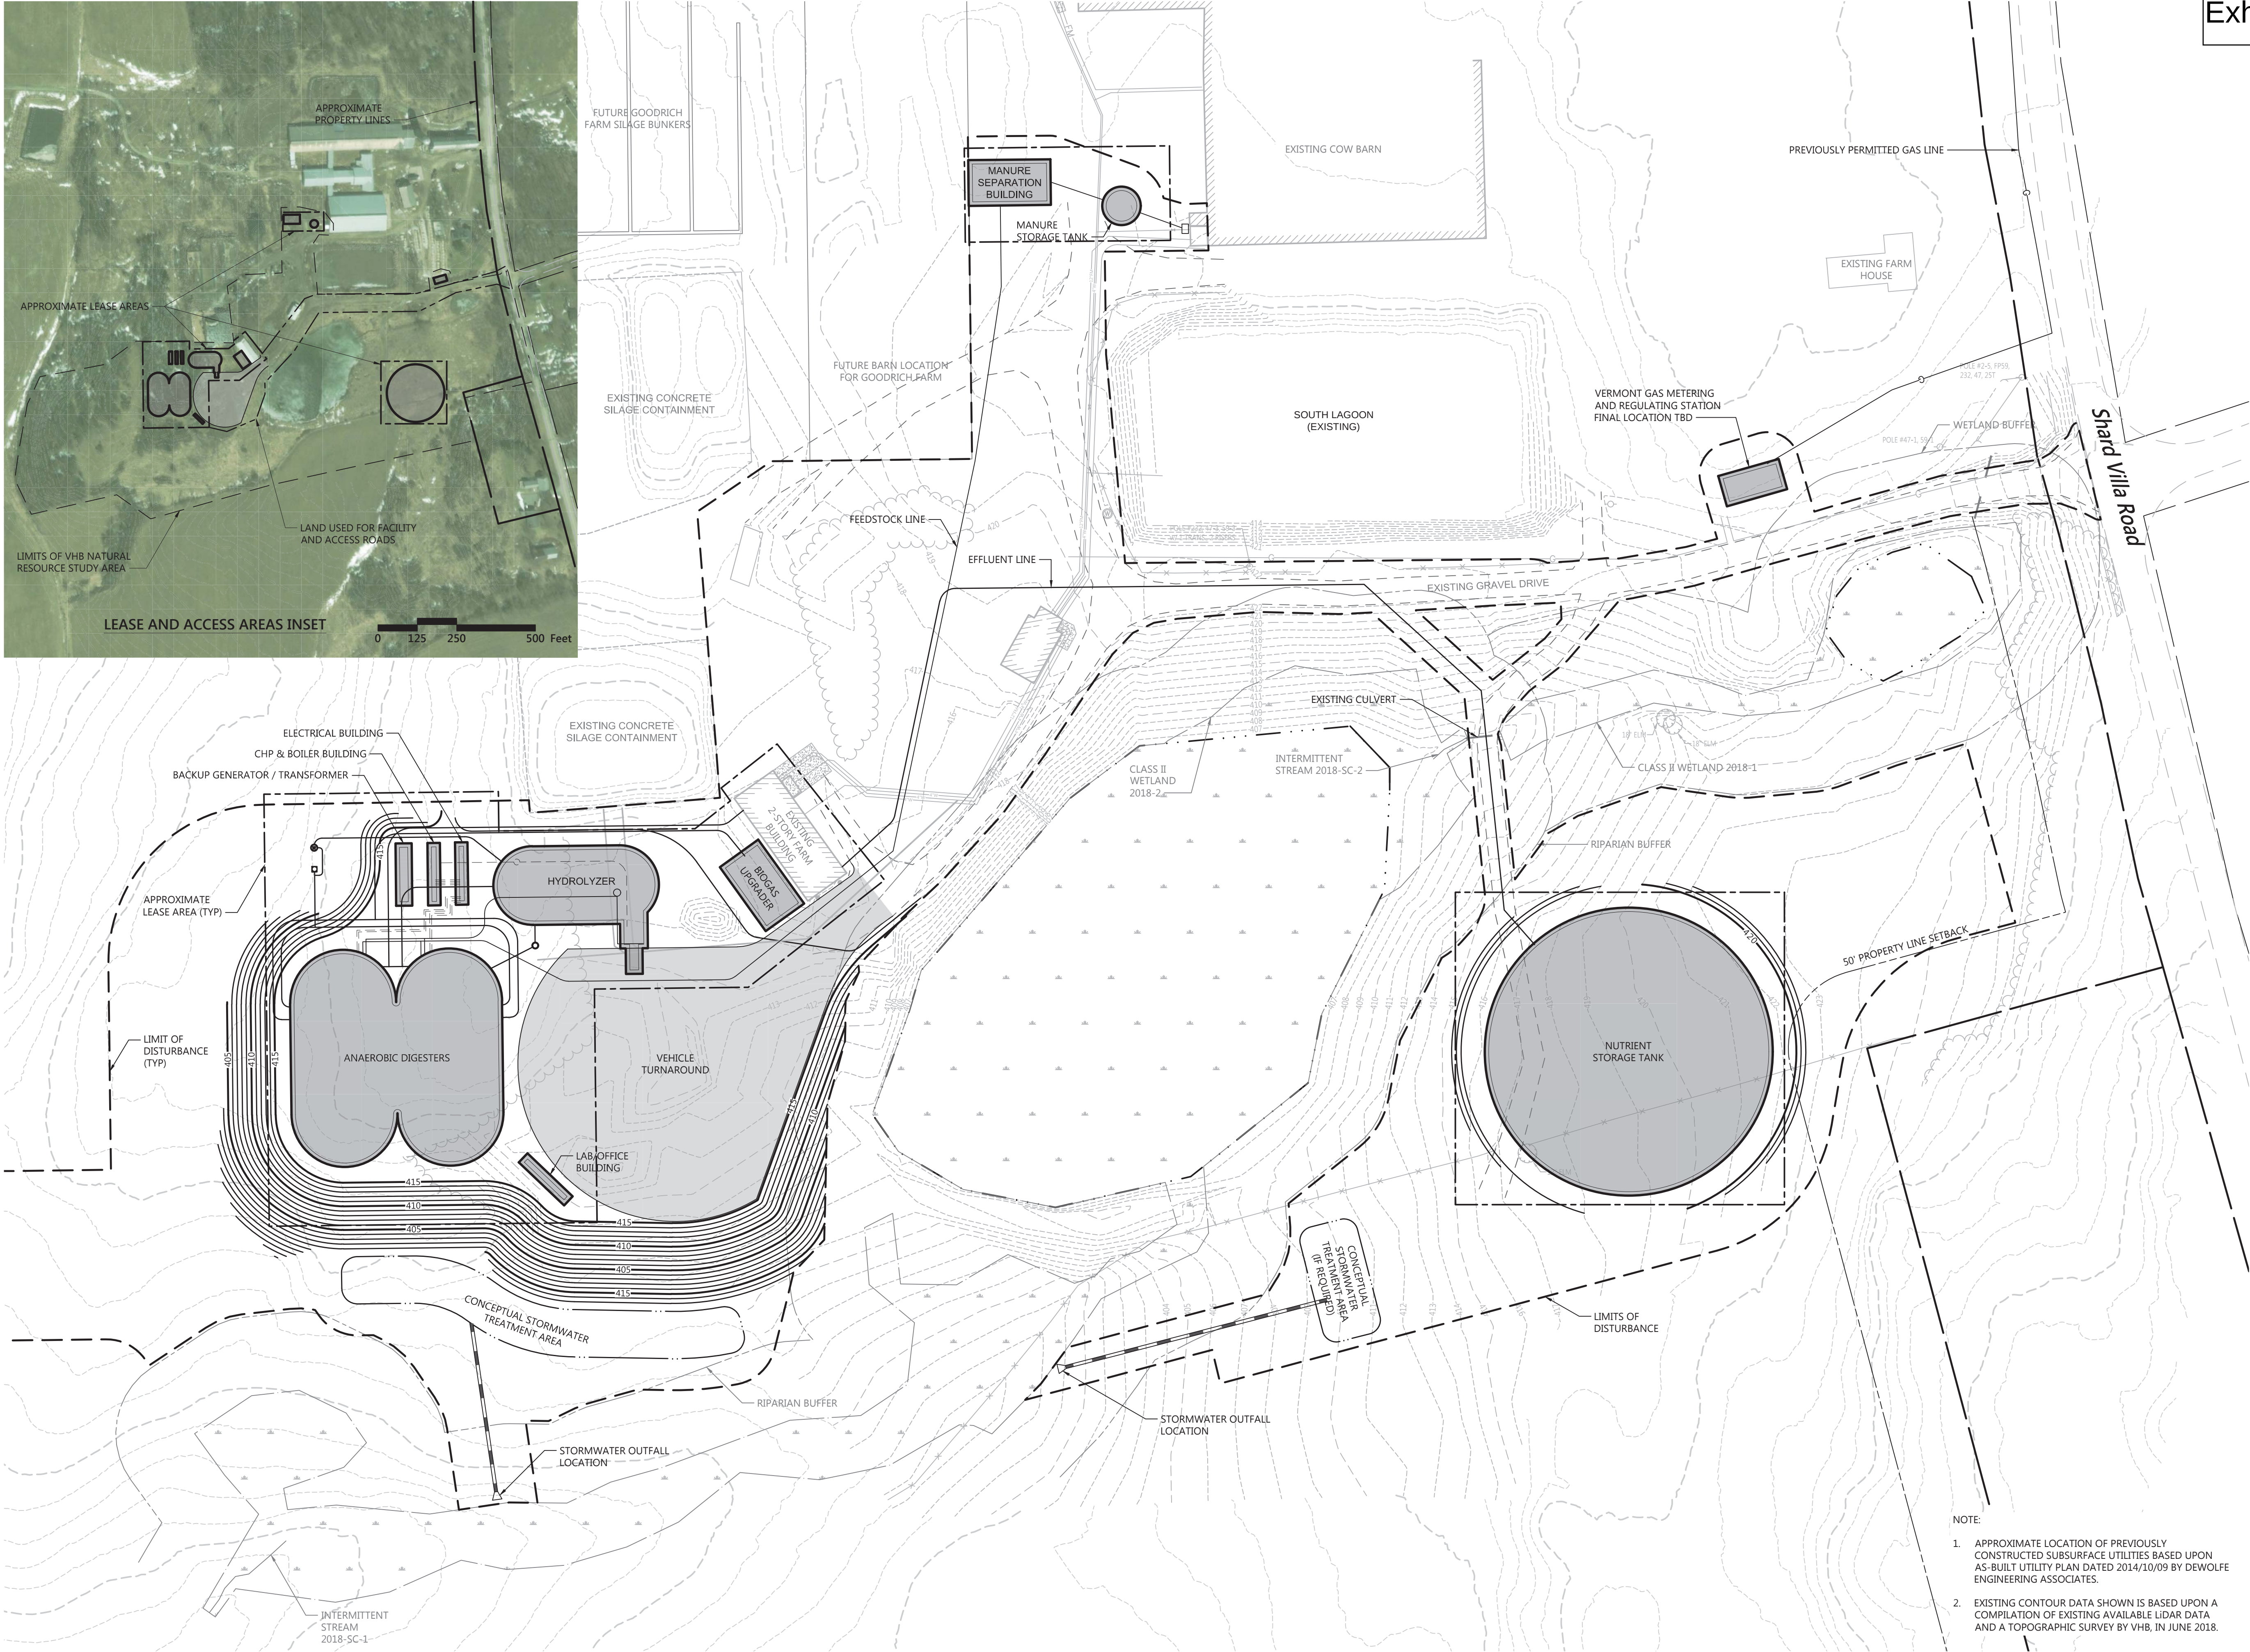
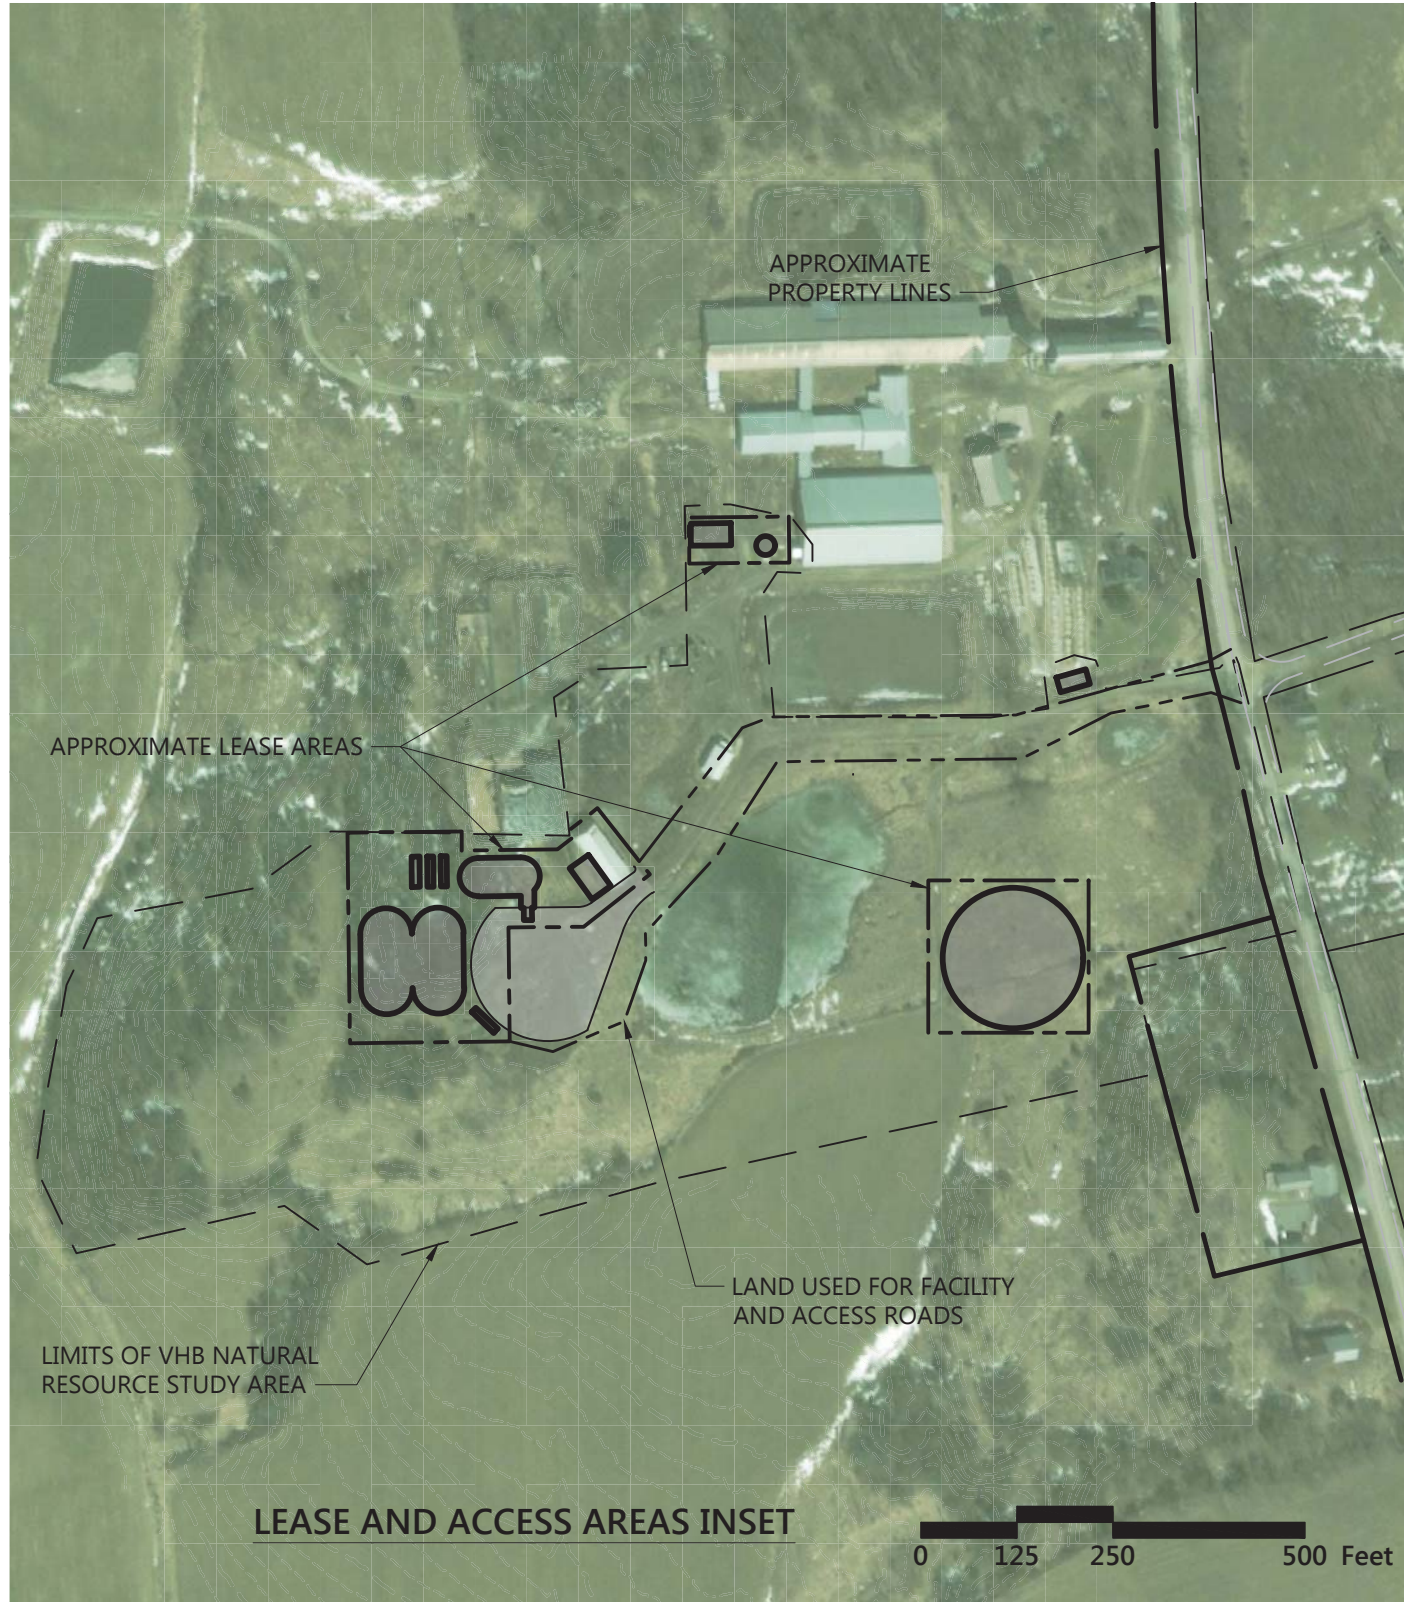


Exhibit SAD1-3

vhb

40 IDX Dr
Building 100 Suite 200
South Burlington, VT 05403
802.497.6100

LEGEND

	MINOR CONTOUR
	MAJOR CONTOUR
	APPROXIMATE PROPERTY LINE
	WETLAND BOUNDARY
	WETLAND BUFFER
	RIPARIAN BUFFER
	STREAM
	EDGE OF GRAVEL
	LIMIT OF DISTURBANCE
	EXISTING TREELINE



**Goodrich Farm /
Salisbury AD1**

615 Shard Villa Road
Salisbury, Vermont

No.	Revision	Date	Apprd.

Designed by	Checked by
Issued for	Date
248 Submittal	Oct. 1, 2018

Not Approved for Construction

Drawing Title

**Final Project
Design Site Plan**

- NOTE:
1. APPROXIMATE LOCATION OF PREVIOUSLY CONSTRUCTED SUBSURFACE UTILITIES BASED UPON AS-BUILT UTILITY PLAN DATED 2014/10/09 BY DEWOLFE ENGINEERING ASSOCIATES.
 2. EXISTING CONTOUR DATA SHOWN IS BASED UPON A COMPILATION OF EXISTING AVAILABLE LIDAR DATA AND A TOPOGRAPHIC SURVEY BY VHB, IN JUNE 2018.




40 IDX Dr
Building 100 Suite 200
South Burlington, VT 05403
802.497.6100

LEGEND

- PROPERTY LINE
- AS-APPROVED PROJECT LAYOUT
- FINAL PROJECT LAYOUT

OCCUR ON BOTH LAYOUTS		9 NUTRIENT MANAGEMENT BUILDING
1 DIGESTER(S)		OCCUR ON FINAL LAYOUT ONLY
2 UTILITY BUILDING		10 CHP BUILDING
3 OFFICE/LAB		11 HYDROLYZER
4 SEPARATOR BUILDING		12 NUTRIENT STORAGE TANK
5 MANURE TANK		13 TRUCK TURNAROUND
6 BIOGAS UPGRADER		14 BACK UP GENERATOR
7 VT GAS METERING STATION		OCCUR ON AS-APPROVED LAYOUT ONLY
8 FLARE		15 EXISTING PUMP HOUSE
		16 COMPOST PAD

NOTES:
1. NOT ALL FACILITY ELEMENTS LISTED ABOVE ARE PRESENT ON BOTH THE CURRENT AND PREVIOUS FACILITY LAYOUT.
* ASSUMED LOCATION

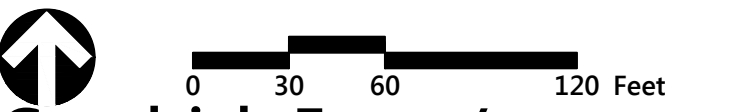

Goodrich Farm /
Salisbury AD1
615 Shard Villa Road
Salisbury, Vermont

No.	Revision	Date	Apprd.

Designed by	Checked by
Issued for	Date

248 Submittal Oct. 1, 2018

Not Approved for Construction

Drawing Title
**Project Layout
Comparison Plan**

Drawing Number

Sheet of

Project Number
58073.00

FINAL PROJECT LAYOUT



AS-APPROVED PROJECT LAYOUT

