



40 IDX Dr
Building 100 Suite 200
South Burlington, VT 05403
802.497.6100

LEGEND

	EFFLUENT LINE
	FEEDSTOCK LINE
	GAS LINE
	MINOR CONTOUR
	MAJOR CONTOUR
	APPROXIMATE PROPERTY LINE
	WETLAND BOUNDARY
	WETLAND BUFFER
	RIPARIAN BUFFER
	STREAM
	EDGE OF GRAVEL
	LIMIT OF DISTURBANCE
	EXISTING TREELINE



Goodrich Farm /
Salisbury AD1

615 Shard Villa Road
Salisbury, Vermont

No.	Revision	Date	Appr'd.
1	Amended 248 Approval	7/2/2020	JZ

Designed by	TAS	Checked by	PBS
-------------	-----	------------	-----

Issued for	248 Submittal	Date	Feb. 6, 2019
------------	---------------	------	--------------

Not Approved for Construction

Revised Proposed Project
Design Site Plan



Drawing Number

C-1.01

Sheet of

Project Number


58073.00

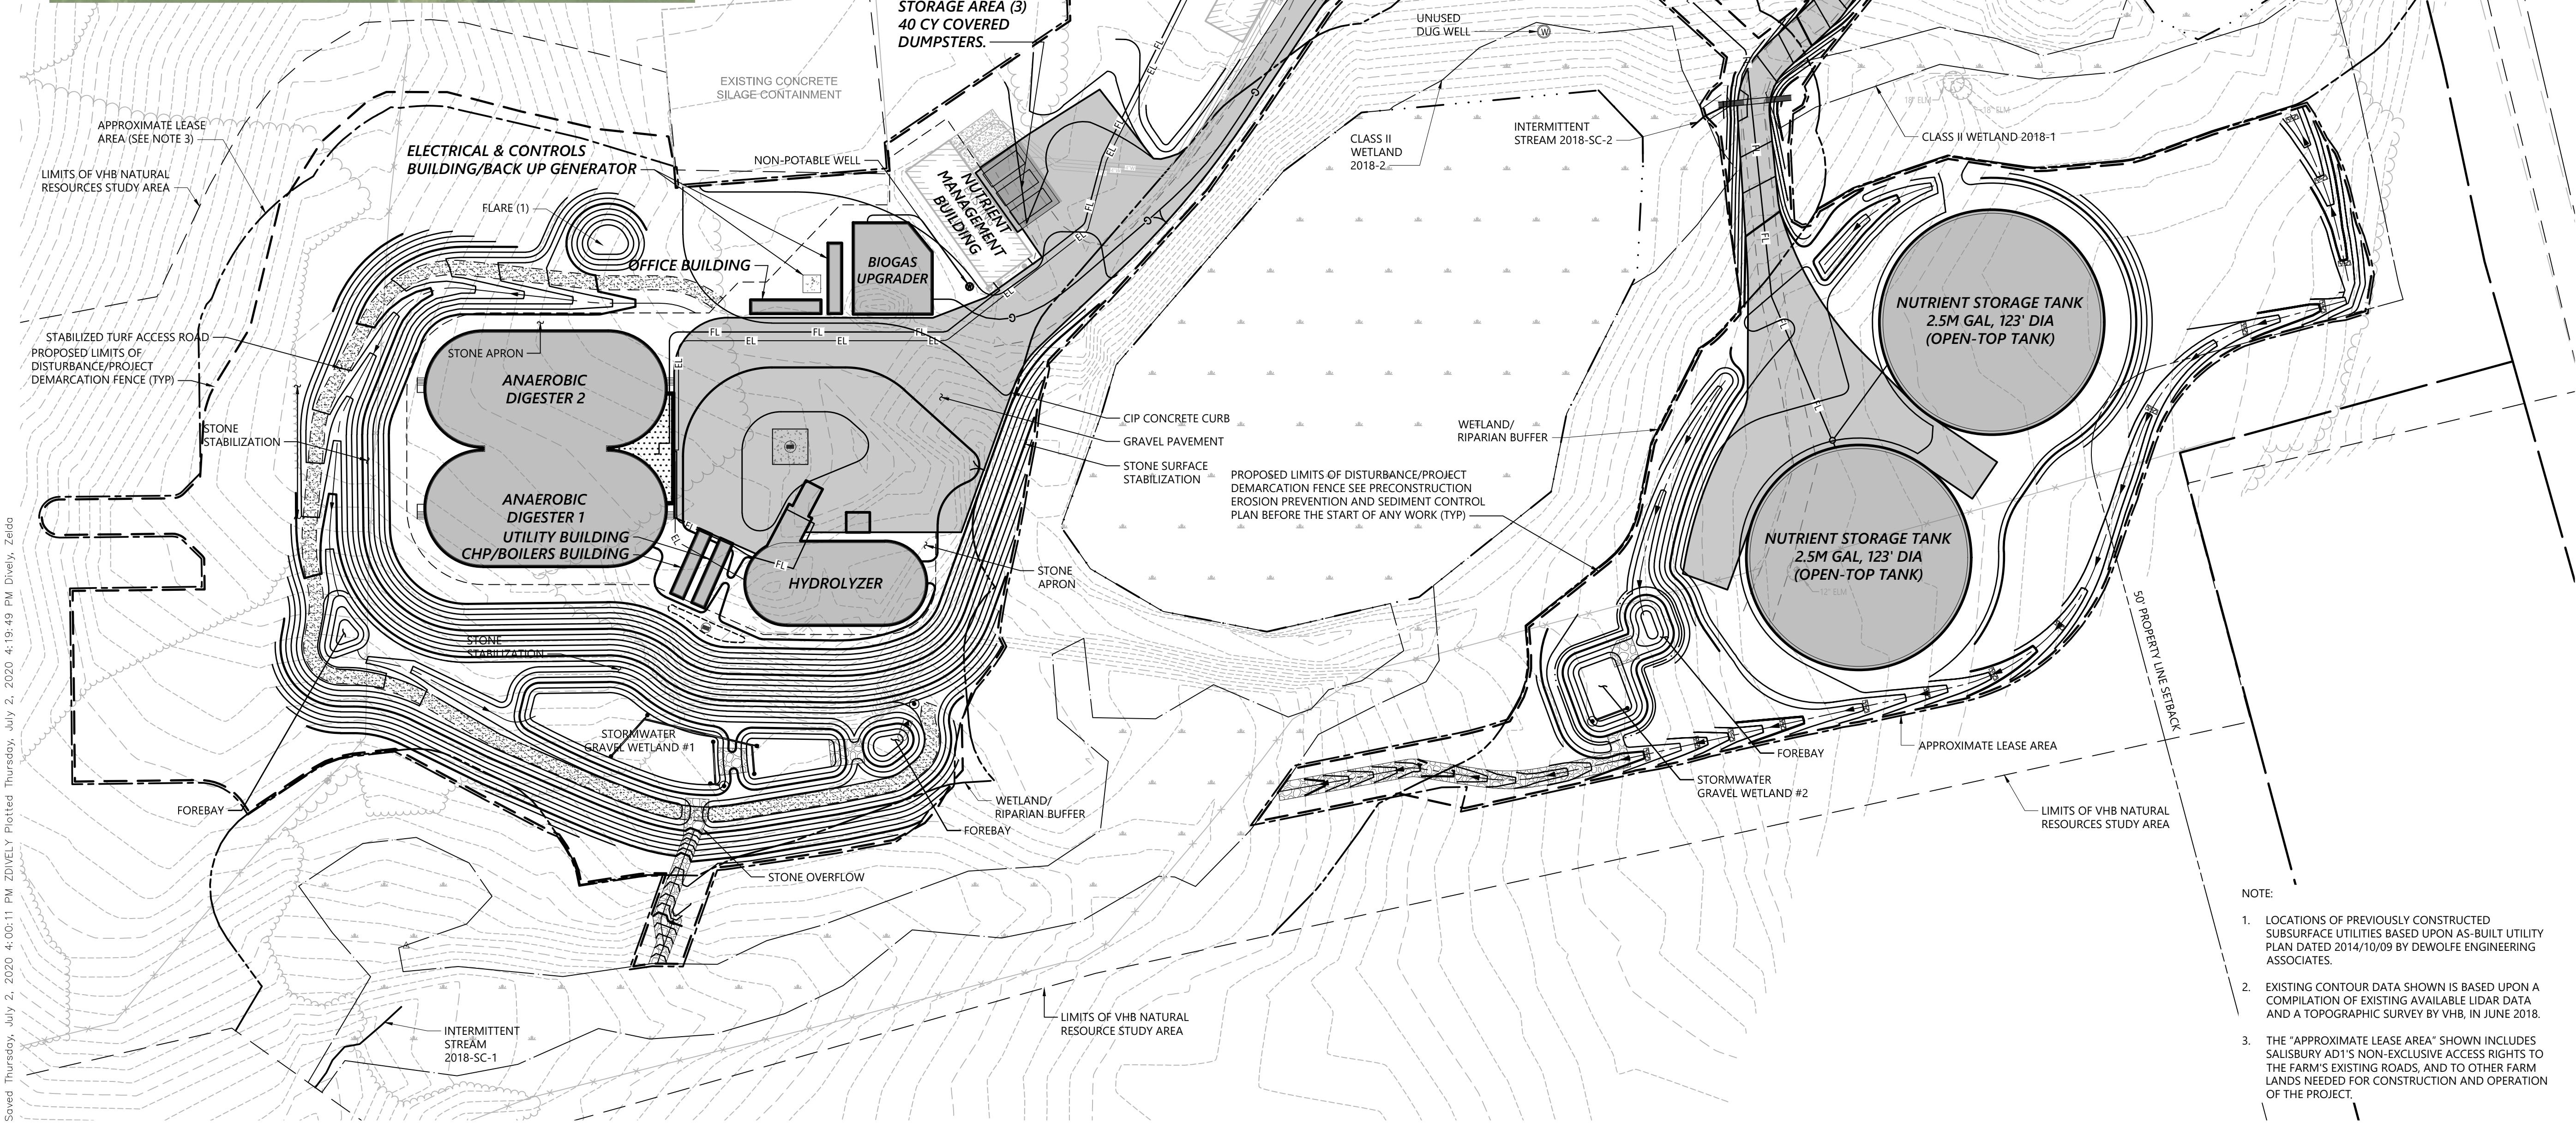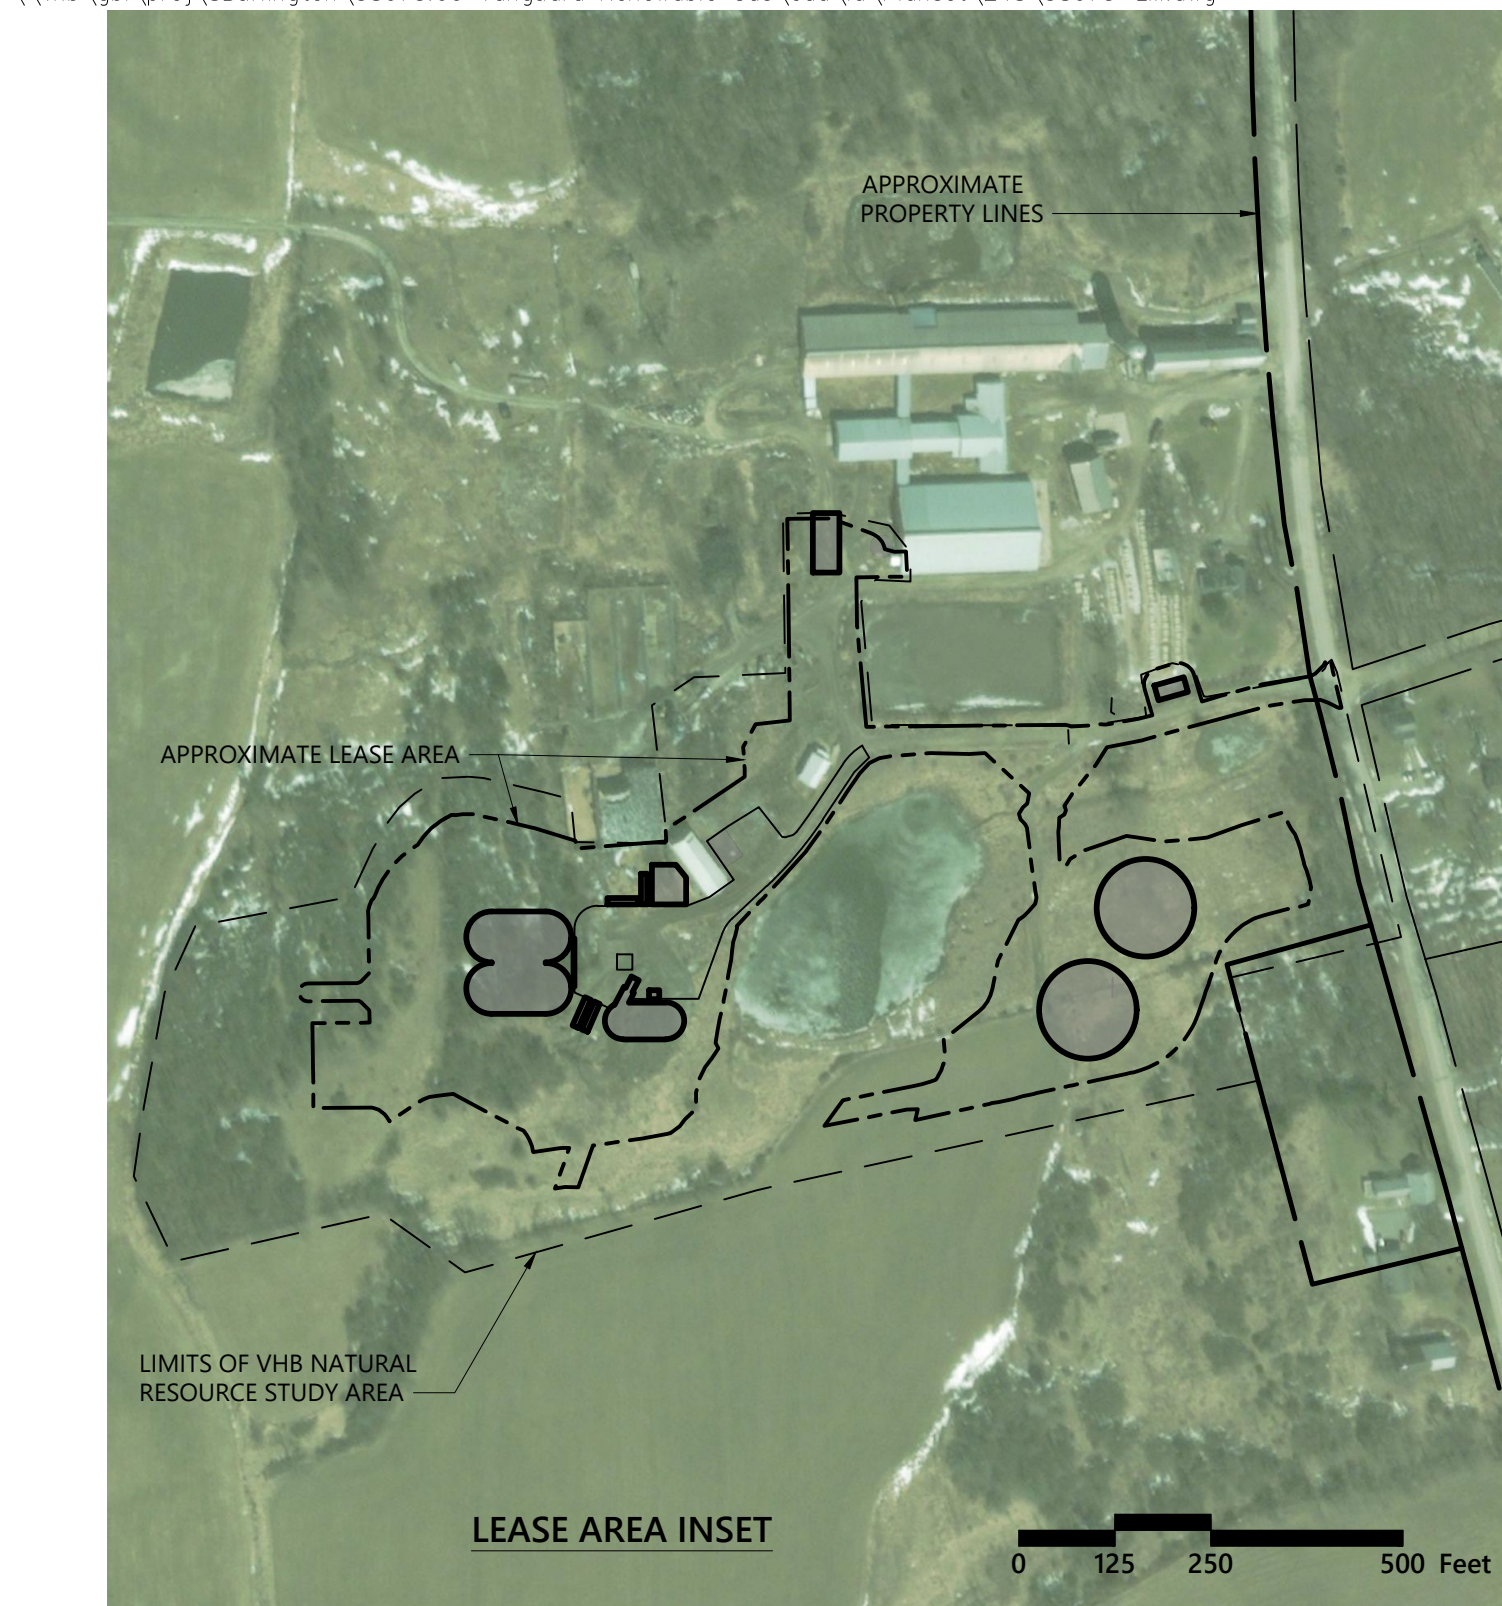


NOTE:

- LOCATIONS OF PREVIOUSLY CONSTRUCTED SUBSURFACE UTILITIES BASED UPON AS-BUILT UTILITY PLAN DATED 2014/10/09 BY DEVOLFE ENGINEERING ASSOCIATES.
- EXISTING CONTOUR DATA SHOWN IS BASED UPON A COMPILATION OF EXISTING AVAILABLE LIDAR DATA AND A TOPOGRAPHIC SURVEY BY VHB, IN JUNE 2018.
- THE "APPROXIMATE LEASE AREA" SHOWN INCLUDES SALISBURY AD1'S NON-EXCLUSIVE ACCESS RIGHTS TO THE FARM'S EXISTING ROADS, AND TO OTHER FARM LANDS NEEDED FOR CONSTRUCTION AND OPERATION OF THE PROJECT.

REVISED PROPOSED PROJECT LAYOUT

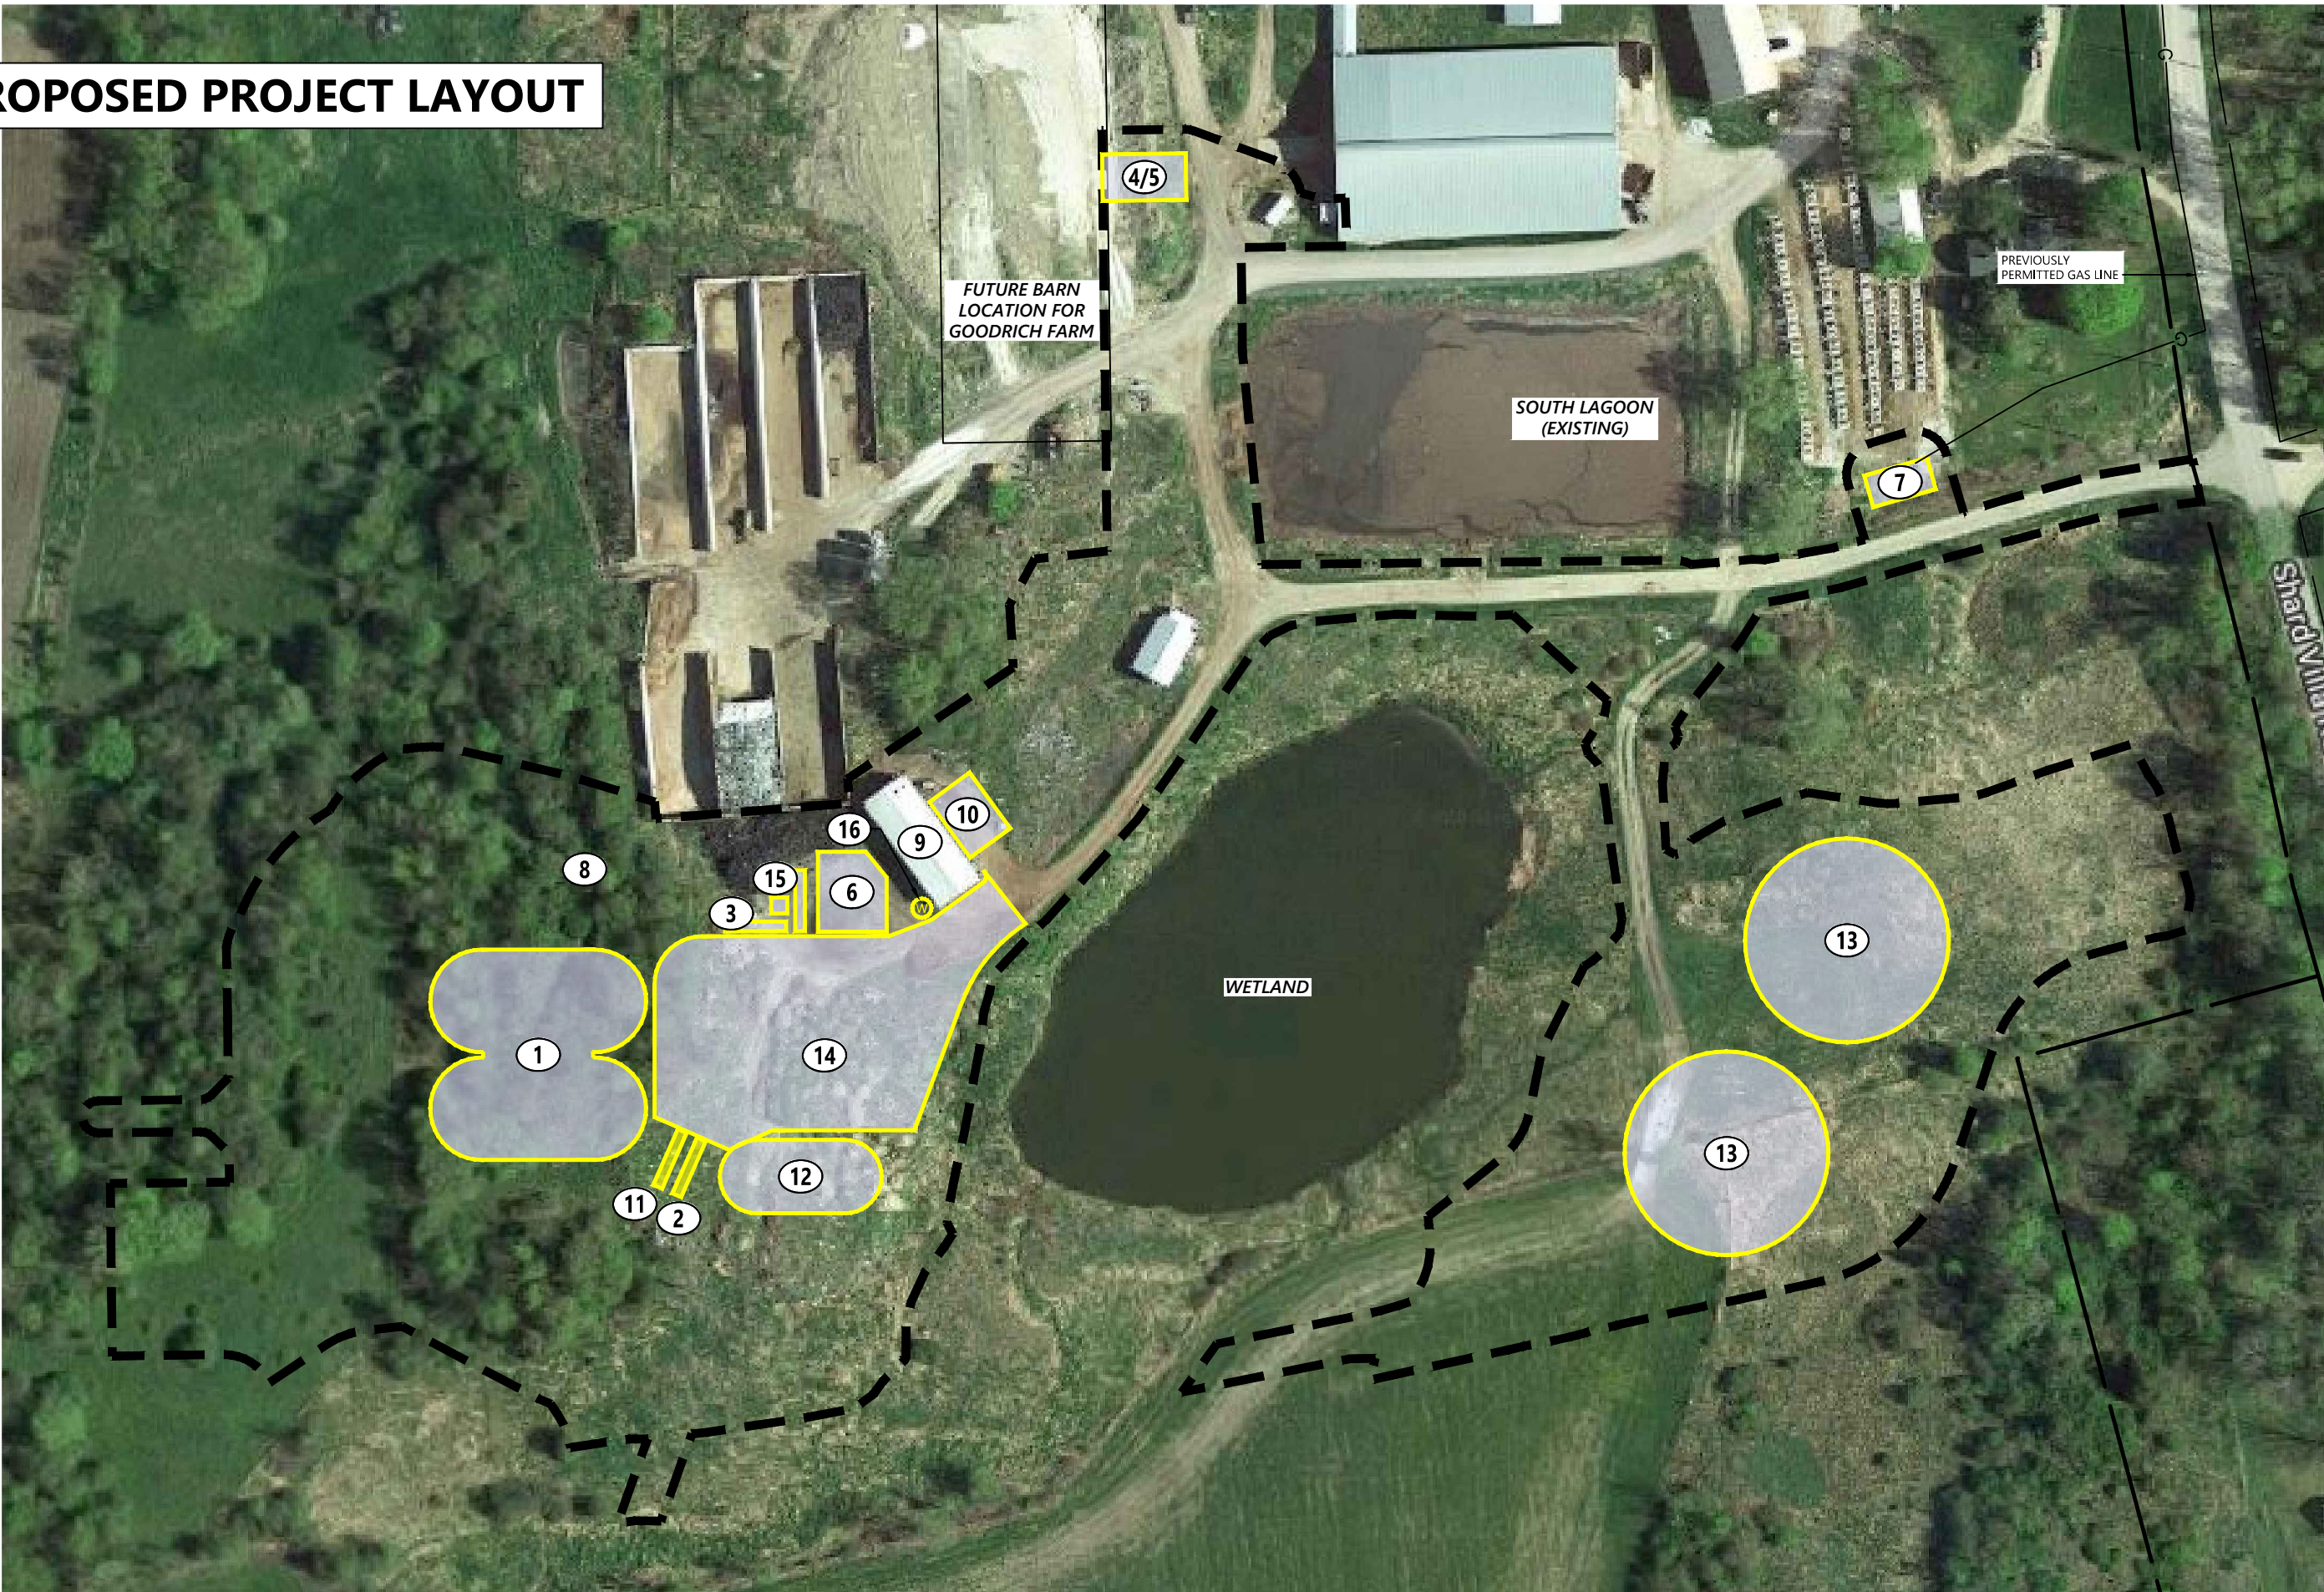

AS-APPROVED PROJECT LAYOUT
(FIRST AMENDMENT, 18-3449-PET)

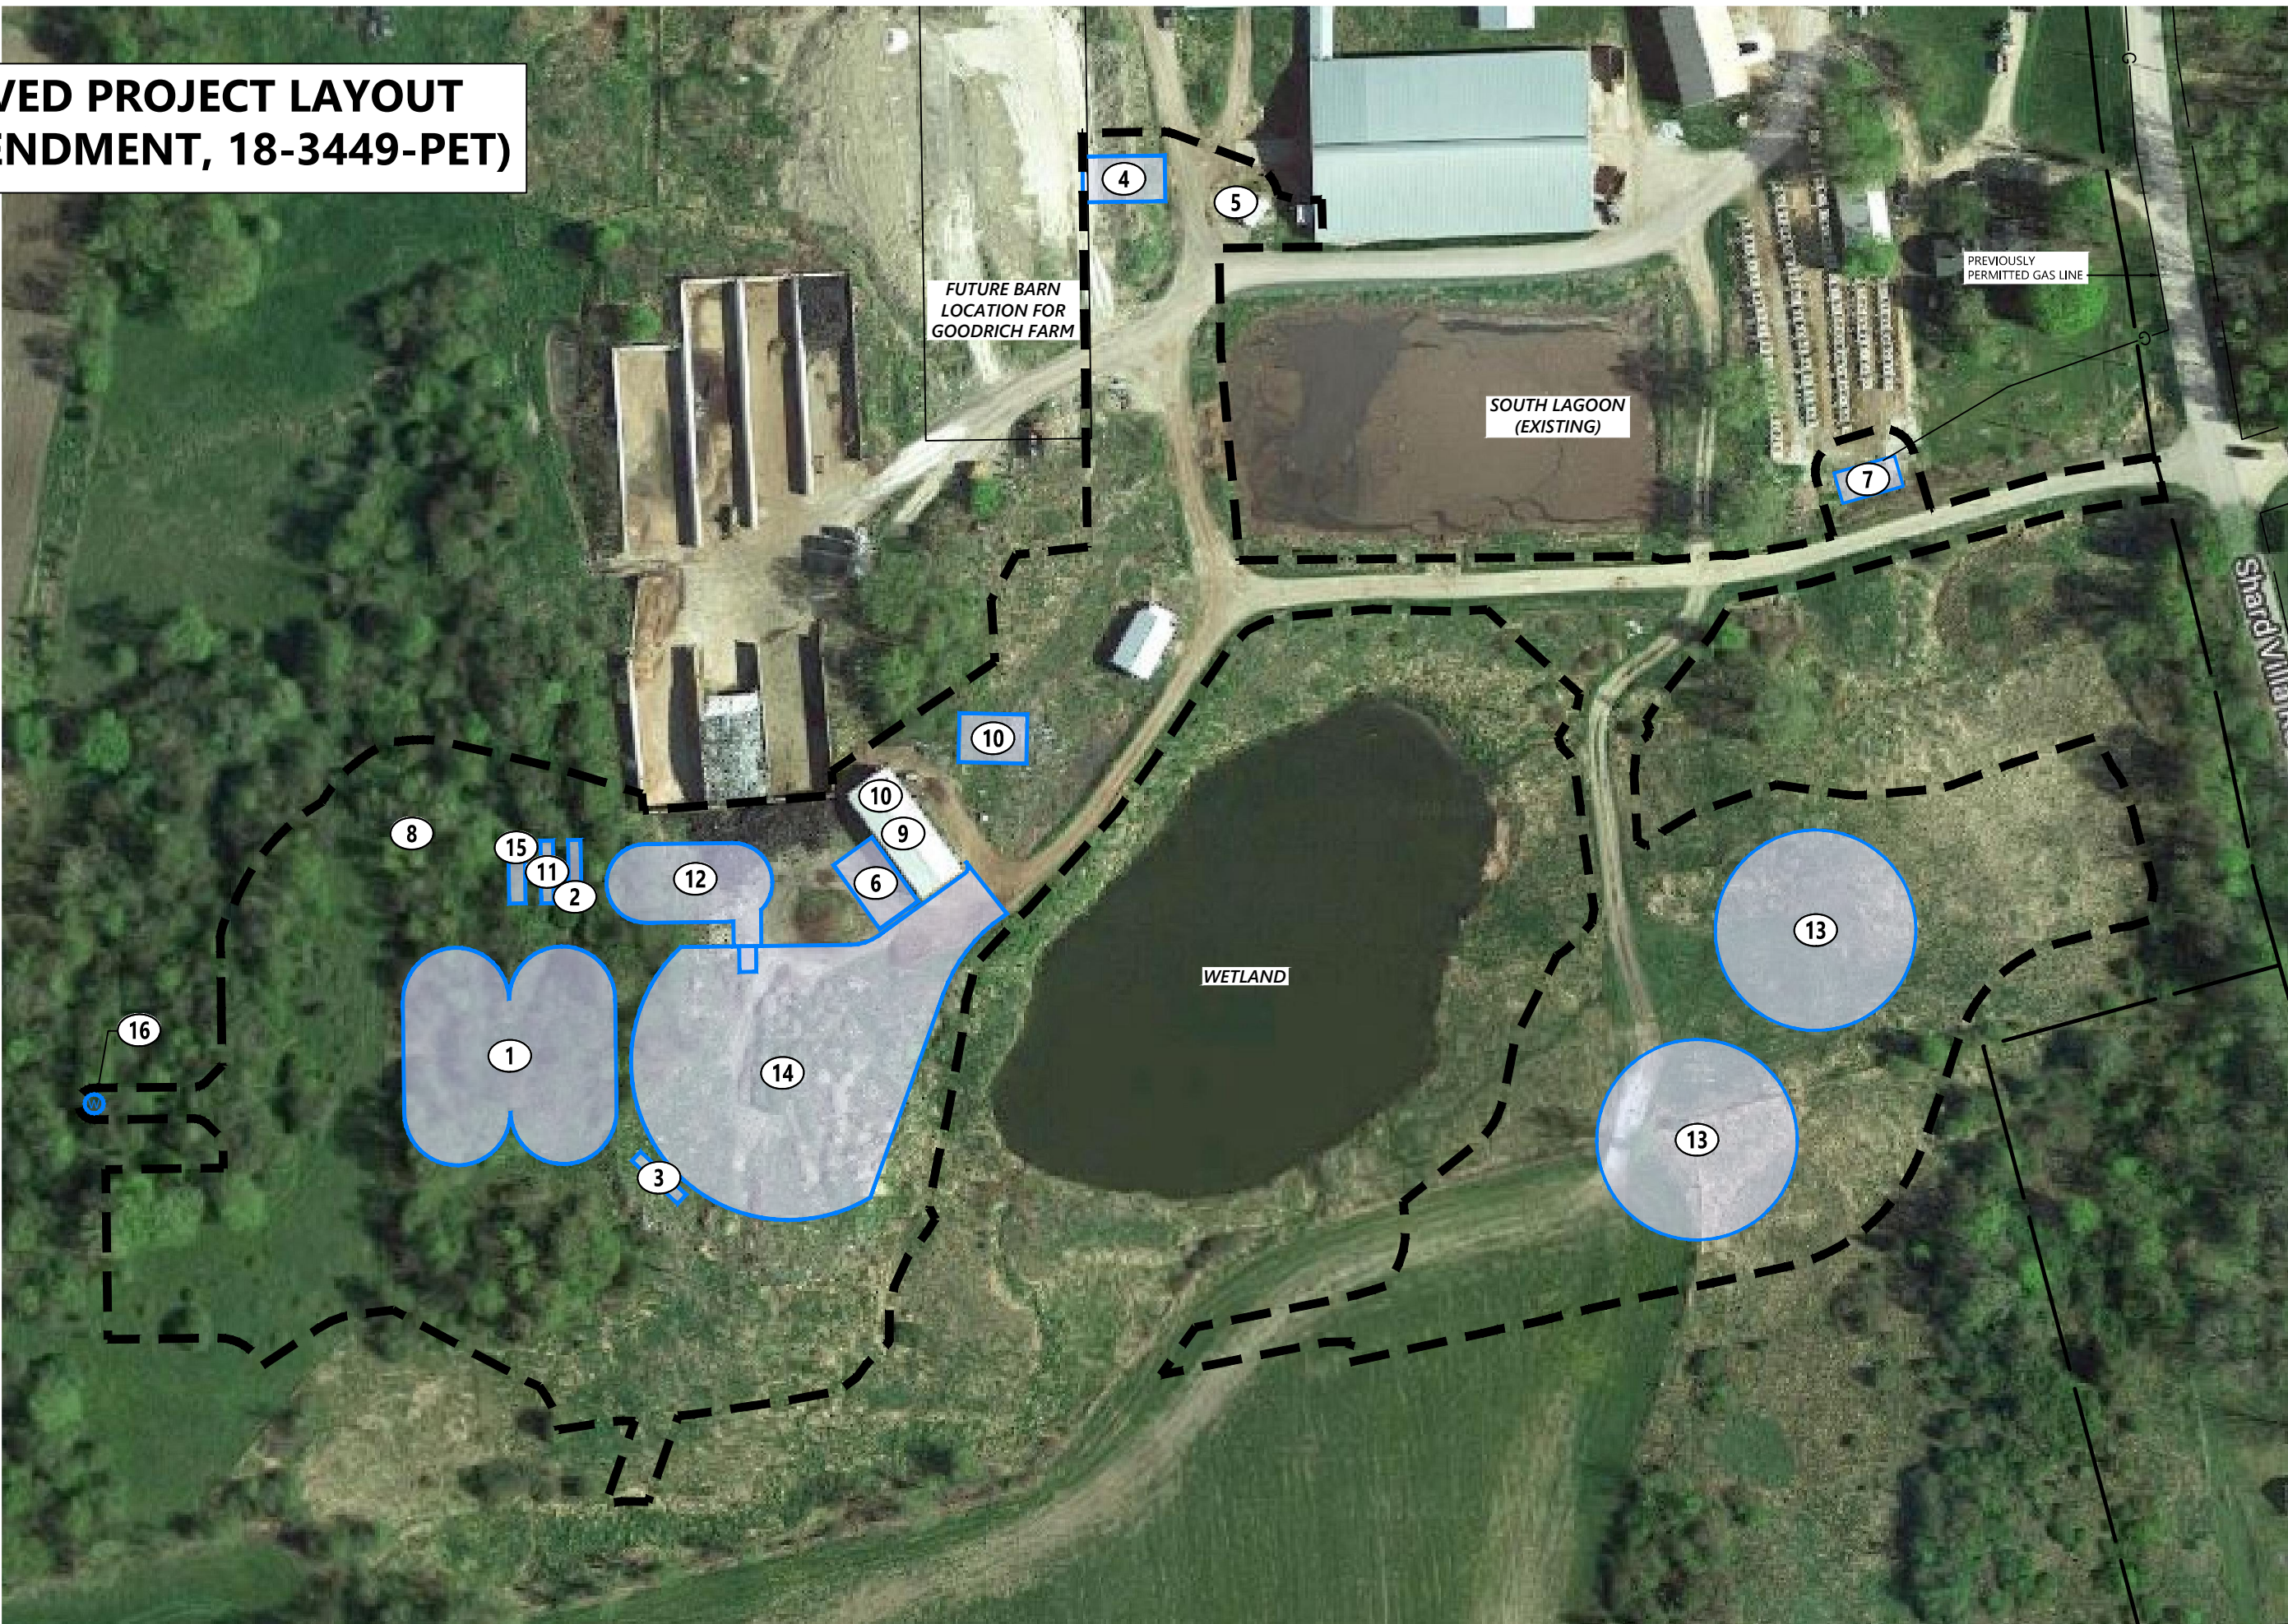



vhb.com

40 IDX Dr
Building 100 Suite 200
South Burlington, VT 05403
802.497.6100

LEGEND

- PROPERTY LINE
- REVISED PROPOSED PROJECT COMPONENTS
- AS-APPROVED PROJECT COMPONENTS
- PROJECT AREA

1 DIGESTER(S)	9 NUTRIENT MANAGEMENT BUILDING
2 UTILITY BUILDING	10 NUTRIENT CAKE STORAGE AREA
3 OFFICE/LAB	11 CHP AND BOILER BUILDING
4 SEPARATOR BUILDING	12 HYDROLYZER
5 MANURE TANK	13 NUTRIENT STORAGE TANK
6 BIOGAS UPGRADER	14 TRUCK TURNAROUND
7 VT GAS METERING STATION	15 ELECTRICAL AND CONTROLS BUILDING/BACK UP GENERATOR
8 FLARE	16 PROCESS WATER WELL



0 50 100 200 Feet

Goodrich Farm /
Salisbury AD1

615 Shard Villa Road
Salisbury, Vermont

No.	Revision	Date	Appr'd.
1	Amended 248 Approval	7/2/2020	JZ

Designed by	Checked by
RWN	JZ
Issued for	Date
248 Submittal	Feb. 6, 2019

Not Approved for Construction

Drawing Title

Project Layout
Comparison Plan

Drawing Number

CP-1

Sheet of

Project Number

58073.00